


BUILDING LEGEND

BUILDING SCHEDULE TERMINAL 91

- A-1 MAREL BUILDING
- A-2 CRUISE TERMINAL BUILDING
- A-11 POS ENGINEERING TRAILER
- A-72 MAIN GATE HOUSE
- A-310 AM SEAFOODS OFFICE BUILDING
- A-400 OFFICE TRAILER
- A-500 OFFICE TRAILER
- A-501 OFFICE TRAILER
- C-155
- C-156
- C-175 AM SEAFOODS
- C-175 CHILL FACILITY
- GH-1 GUARD HOUSE
- GH-2 GUARD HOUSE
- GH-3 GUARD HOUSE
- M-4 SCL MAIN SUBS. SOUTH (M55-1)
- M-19
- M-19A
- M-25
- M-28 SEAFOOD PROCESS BLDG.
- M-86 CITY ICE
- M-309 POS ELECTRICIANS OFFICE
- W-39 COLD STORAGE WAREHOUSE
- W-40 CITY ICE
- W-300 TRIDENT BUILDING
- W-390 COLD STORAGE WAREHOUSE

RAILROAD SWITCHING
RESPONSIBILITY OF
BURLINGTON NORTHERN.

- LEASE HOLD AREA
- PREFERENTIAL USE AREA
- PARKING AREA

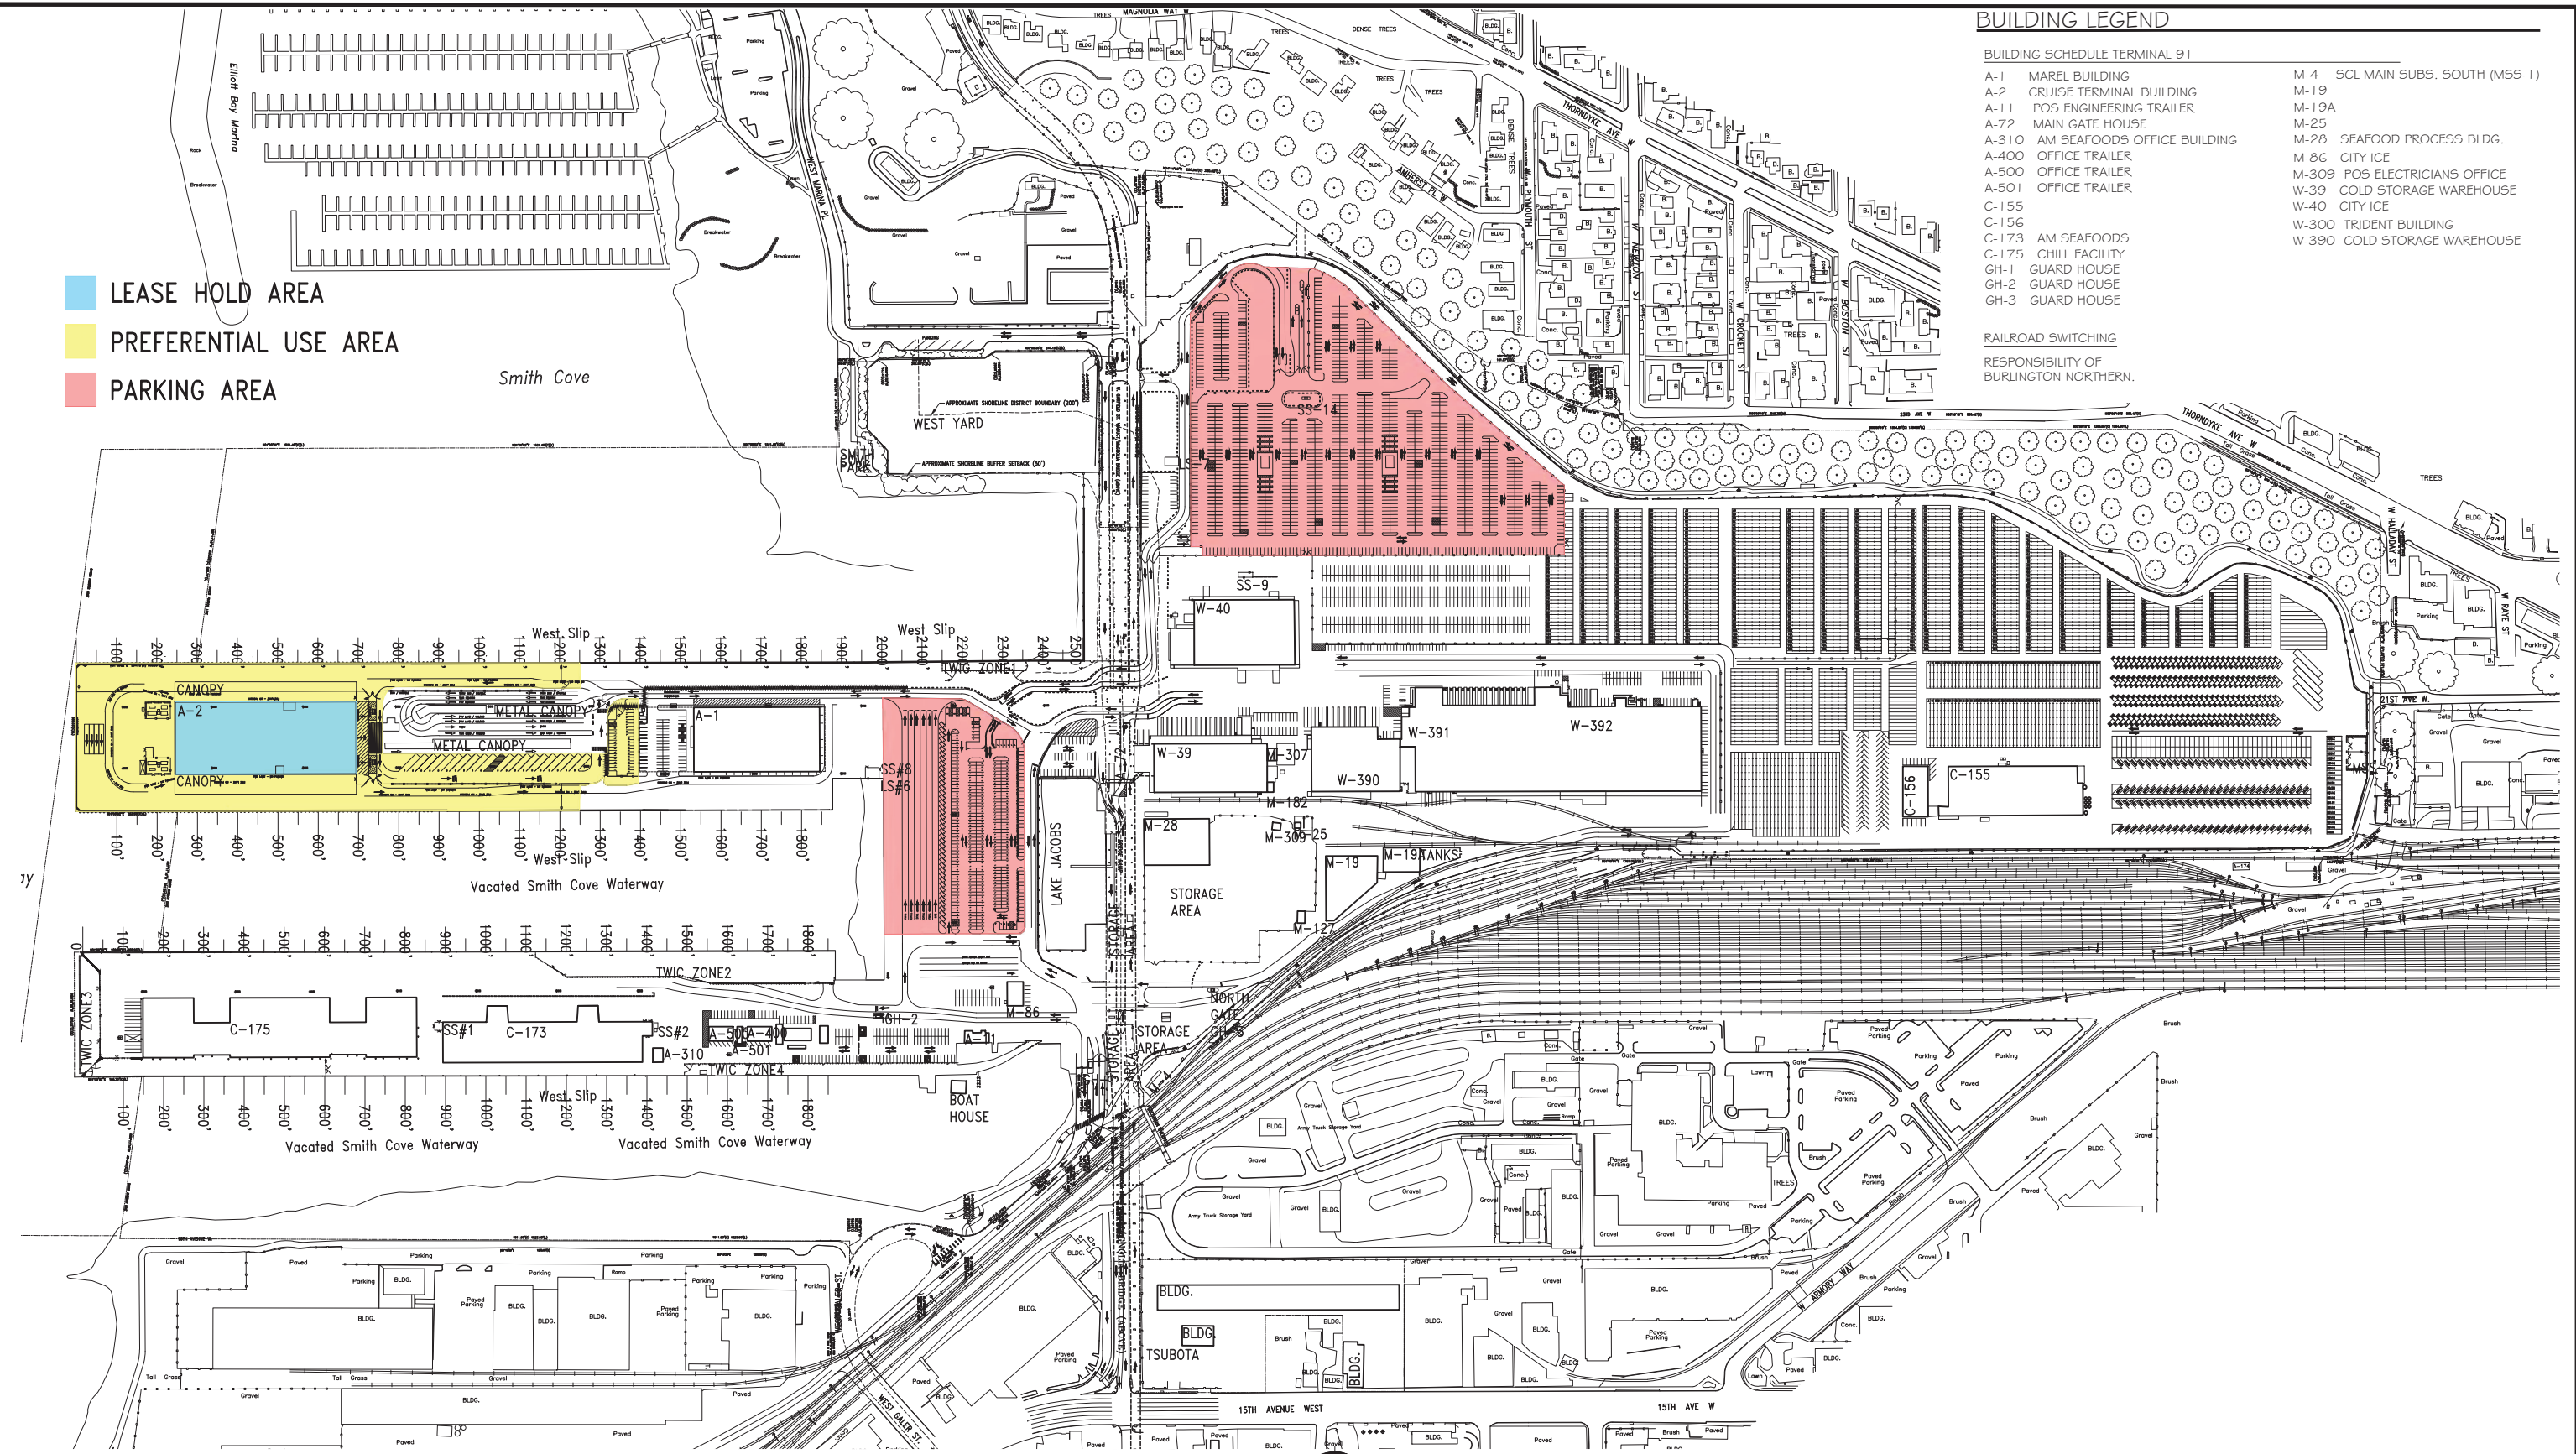

SUBCLASS PLAN

TERMINAL 91
SCALE: 1:200



THIS AS-BUILT DRAWING WAS CONSOLIDATED FROM MULTIPLE SOURCES. TO BE USED FOR REFERENCE ONLY. SITE VERIFICATION IS ADVISED.

PROJECT ENGR./ARCH:
DESIGNER:
DRAWN BY:
SCALE:
DATE:
CHECKED BY:
CHECKED/APPROVED BY:

REVISIONS						
NO.	DATE	BY	DESCRIPTION	APP'D	NO.	DATE

PROJECT MANAGER:
PROJECT ENGINEER:
DESIGN ENGINEER:
DRAFTER: ERNANI NARAG
SCALE: 1:200
DATE: FEB. 2025
CHECKED/APPROVED BY:

MARINE FACILITIES

TERMINAL 91 CTA LEASE AREA

SHEET TITLE: **SITE PLAN**

TERMINAL 90-91

WORK PROJECT NO.

CONSULTANT'S NO.

PORT OF SEATTLE NO.

C1.0 91-MM1603

